


AS-BUILT
4-25-20

AS-BUI
4-25-2

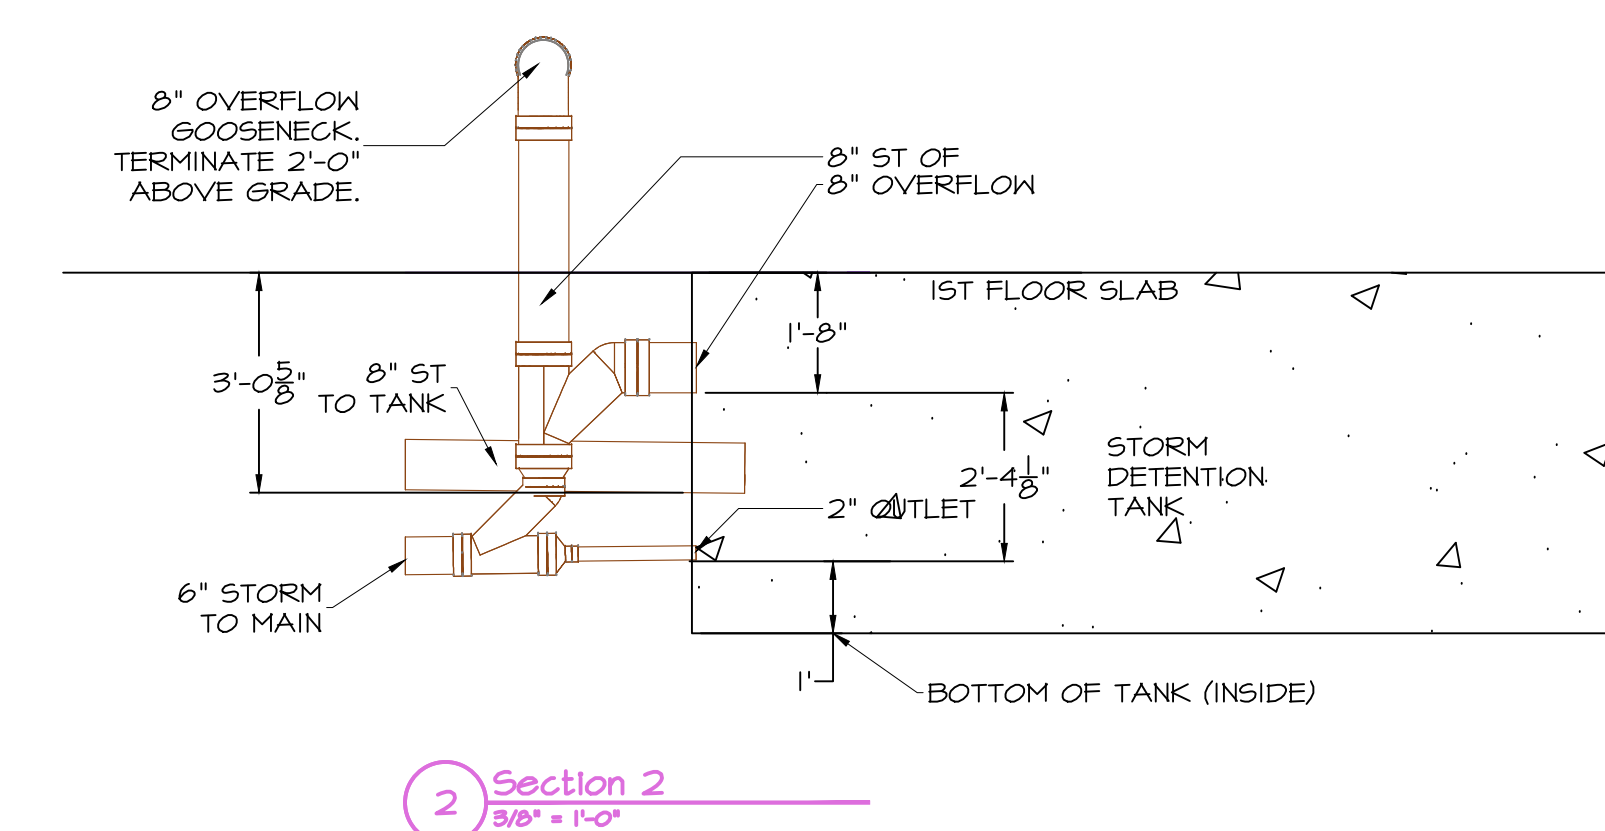

JOB NAME & ADDRESS		MECHANICAL CONTRACTOR		DESIGNER - DETAILER		LAYOUT BASED ON		MEP Coordination Sign-Off Box	
203 GREENE AVE BROOKLYN, NY 11238		Tel. (718) 858-9833 G. N. Mechanical 612 7th Street Brooklyn, New York 11209		 3D EDGE LLC MEP COORDINATION SERVICES		PROJECT BRAND RELEASE		The undersigned hereby certifies that the drawings, specifications, and documents attached to this contract were prepared by the undersigned or under the direct supervision and control of the undersigned, and that the undersigned is a duly licensed professional engineer in the State of New York.	
REVISIONS		MECHANICAL CONTRACTOR		DESIGNER - DETAILER		LAYOUT BASED ON		MEP Coordination Sign-Off Box	
1. REVISED 2. REVISED Tel. (718) 858-9833 G. N. Mechanical 612 7th Street Brooklyn, New York 11209		 3D EDGE LLC MEP COORDINATION SERVICES		PROJECT BRAND RELEASE		The undersigned hereby certifies that the drawings, specifications, and documents attached to this contract were prepared by the undersigned or under the direct supervision and control of the undersigned, and that the undersigned is a duly licensed professional engineer in the State of New York.	
1ST FLOOR UNDERGROUND PLUMBING LAYOUT		P-101-UG		P-101-UG		P-101-UG		P-101-UG	